

8th Floor
5,305 RSF
(AS-BUILT PLAN)

SPONSORSHIP



LEASING

Phil Dickinson
202-266-1156
philip.dickinson@cushwake.com



James Collins
202-266-1188
james.collins@cushwake.com



CERTIFICATIONS



1401Hst.com

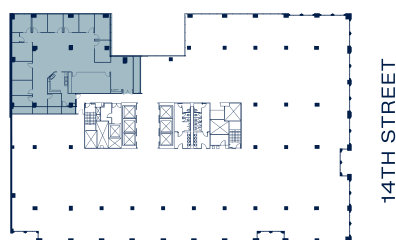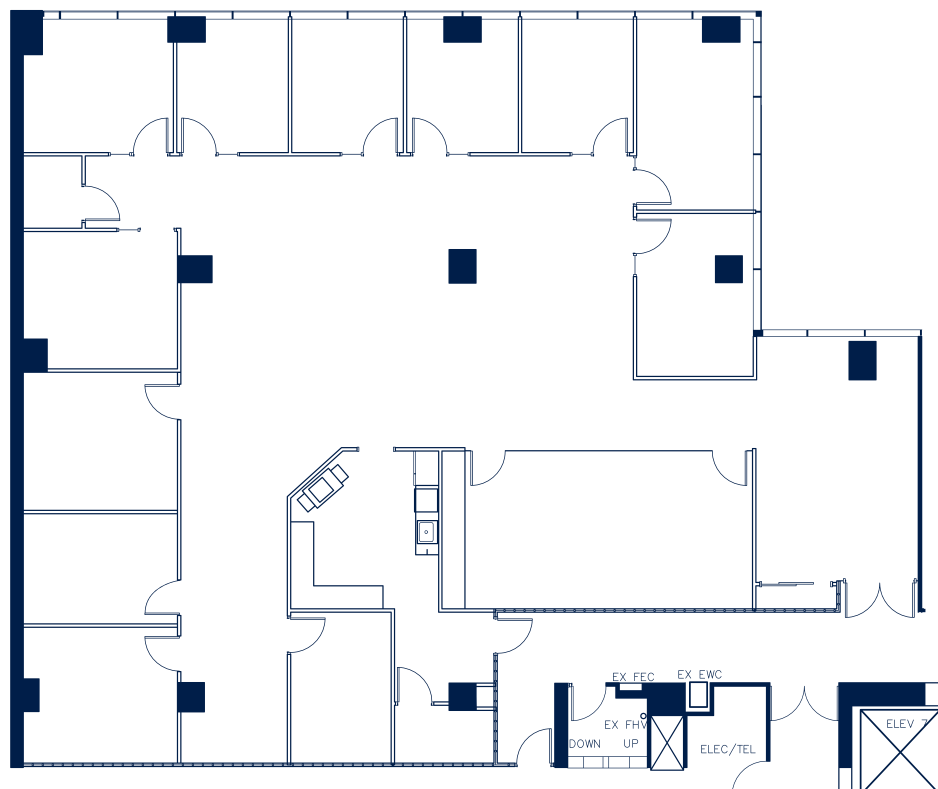

H STREET

14TH STREET

